

Date: Monday, 1/16/2006 4:11:20 PM  
 User: Kim Johnston

## Process Sheet

|                                    |   |                           |                                      |
|------------------------------------|---|---------------------------|--------------------------------------|
| <b>Customer</b> :                  | CU-DAR001 Dart Helicopters Services         | <b>Drawing Name</b> :     | COLLECTIVE LOCK                      |
| <b>Job Number</b> :                | 25501                                       |                           |                                      |
| <b>Estimate Number</b> :           | 11948                                       |                           |                                      |
| <b>P.O. Number</b> :               | N/A   | <b>Part Number</b> :      | D3372041                             |
| <b>This Issue</b> :                | 1/16/2006                                   | <b>S.O. No.</b> :         | N/A                                  |
| <b>Prsht Rev.</b> :                | NC  | <b>Drawing Number</b> :   | D3372 REV B                          |
| <b>First Issue</b> :               | N/A   | <b>Project Number</b> :   | N/A                                  |
| <b>Previous Run</b> :              | N/A   | <b>Drawing Revision</b> : | B                                    |
|                                    | <b>Type</b> :                               | <b>Material</b> :         | N/A                                  |
|                                    | SMALL / MED FAB                             | <b>Due Date</b> :         | 1/20/2006                            |
| <b>Written By</b> :                | <u>SEE COMMENT BELOW</u>                    |                           | <b>Qty:</b> <u>4</u> <b>Um:</b> Each |
| <b>Checked &amp; Approved By</b> : | <u>SEE COMMENT BELOW</u>                    |                           |                                      |
| <b>Comment</b> :                   | Est Rev:A Removed from 9 Digit 06-01-13 JLM |                           |                                      |

## Additional Product

Job Number:



|                |                              |                      |
|----------------|------------------------------|----------------------|
| <b>Seq. #:</b> | <b>Machine Or Operation:</b> | <b>Description :</b> |
|----------------|------------------------------|----------------------|

|     |        |       |
|-----|--------|-------|
| 1.0 | D27287 | Decal |
|-----|--------|-------|



**Comment:** Qty.: 1.0000 Each(s)/Unit Total : 5.0000 Each(s)

Pick:

Qty Part Number Description Batch

1 D2728-7 Decal B 22554

|     |        |           |
|-----|--------|-----------|
| 2.0 | D33721 | Main Body |
|-----|--------|-----------|



**Comment:** Qty.: 1.0000 Each(s)/Unit Total : 5.0000 Each(s)

Pick:

Qty Part Number Description Batch

1 D3372-1 Main Body B 22228

|     |        |                |
|-----|--------|----------------|
| 3.0 | D33725 | Cam Lock Shaft |
|-----|--------|----------------|



**Comment:** Qty.: 1.0000 Each(s)/Unit Total : 5.0000 Each(s)

Pick:

Qty Part Number Description Batch

1 D3372-5 Cam Lock Shaft B 22290

|     |        |             |
|-----|--------|-------------|
| 4.0 | D33727 | Slider Body |
|-----|--------|-------------|



**Comment:** Qty.: 1.0000 Each(s)/Unit Total : 5.0000 Each(s)

Pick:

Qty Part Number Description Batch

1 D3372-7 Slider Body B 22291

| W/O: |      | WORK ORDER CHANGES |    |      |     |                                     |                          |
|------|------|--------------------|----|------|-----|-------------------------------------|--------------------------|
| DATE | STEP | PROCEDURE CHANGE   | By | Date | Qty | Approval<br>Chief Eng /<br>Prod Mgr | Approval<br>QC Inspector |
|      |      |                    |    |      |     |                                     |                          |
|      |      |                    |    |      |     |                                     |                          |

Part No: D3372-041 PAR #: N/A Fault Category: Prod / FMS ASS LAGE NCR: Yes No DQA: Yes Date: 06/02/02  
 QA: N/C Closed: Yes Date: 06/02/02

| NCR: <u>25501</u> |      | WORK ORDER NON-CONFORMANCE (NCR)   |                             |   |                |                                |                       |                                |
|-------------------|------|--|-----------------------------|---|----------------|--------------------------------|-----------------------|--------------------------------|
| DATE              | STEP | Description of NC<br>Section A   | Corrective Action Section B |   |                | Verification<br>Section C      | Approval<br>Chief Eng | Approval<br>QC Inspector       |
|                   |      |  | Initial<br>Chief Eng        | Action Description<br>Chief Eng               | Sign &<br>Date |                                |                       |                                |
| 06/02/01          | 16   | 2 Lock were<br>perap after<br>welding  | <i>[Signature]</i>          | Scrap + destroy<br><del>replace</del> replace | SB<br>06/02/01 | <i>[Signature]</i><br>06-02-01 | <i>[Signature]</i>    | <i>[Signature]</i><br>06-02-01 |
| 06/02/01          | 16   | D3372-041<br>1 part had the<br>wrong keys. Keys<br>were identify wrong<br>+ 2 D3372-041 was burned<br>by the welding / | <i>[Signature]</i>          | Scrap + destroy<br>replace                    | SB<br>06/02/02 | <i>[Signature]</i><br>06-02-02 | <i>[Signature]</i>    | <i>[Signature]</i><br>06-02-02 |
|                   |      |  |                             |   |                |                                |                       |                                |

NOTE: Date & initial all entries

Date: Monday, 1/16/2006 4:11:20 PM  
User: Kim Johnston

## Process Sheet

Customer: CU-DAR001 Dart Helicopters Services

Drawing Name: COLLECTIVE LOCK

Job Number: 25501

Part Number: D3372041

Job Number:



Seq. #:

Machine Or Operation:

Description :

5.0

D33731KA

Inventory



Comment: Qty.: 1.0000 Each(s)/Unit Total : 5.0000 Each(s)

Pick:

Qty Part Number Description Batch

1 D3373-1 Cam Lock ~~B22157~~ B23643

6.0

AN542A

Bolt



Comment: Qty.: 1.0000 Each(s)/Unit Total : 5.0000 Each(s)

Pick:

Qty Part Number Description Batch

1 AN5-42A Bolt M16762

7.0

516WC

SS Flat Washer 5/16



Comment: Qty.: 1.0000 Each(s)/Unit Total : 5.0000 Each(s)

Pick:

Qty Part Number Description Batch

1 5/16WC SS Flat Washer M19611

A/RN/ALocktite 262 M16507

8.0

D33841

Cyclic Sock



Comment: Qty.: 1.0000 Each(s)/Unit Total : 5.0000 Each(s)

Pick:

Qty Part Number Description Batch

1 D3384-1 Cyclic Sock B22346

9.0

CBL460

Loop Sleeve



Comment: Qty.: 2.0000 Each(s)/Unit Total : 10.0000 Each(s)

Pick:

Qty Part Number Description Batch

2 CBL-460 Loop Sleeve B19474

10.0

CBL1240

Cable



Comment: Qty.: 0.6999 f(s)/Unit Total : 3.4997 f(s)

Pick:

Qty Part Number Description Batch

8" CBL-1240 Cable M16713

| W/O: |      | WORK ORDER CHANGES |    |      |     |                                     |                          |
|------|------|--------------------|----|------|-----|-------------------------------------|--------------------------|
| DATE | STEP | PROCEDURE CHANGE   | By | Date | Qty | Approval<br>Chief Eng /<br>Prod Mgr | Approval<br>QC Inspector |
|      |      |                    |    |      |     |                                     |                          |
|      |      |                    |    |      |     |                                     |                          |

Part No: \_\_\_\_\_ PAR #: \_\_\_\_\_ Fault Category: \_\_\_\_\_ NCR: Yes No DQA: \_\_\_\_\_ Date: \_\_\_\_\_

QA: N/C Closed: \_\_\_\_\_ Date: \_\_\_\_\_

| NCR: |      | WORK ORDER NON-CONFORMANCE (NCR) |                             |                                 |                |                           |                       |                          |
|------|------|----------------------------------|-----------------------------|---------------------------------|----------------|---------------------------|-----------------------|--------------------------|
| DATE | STEP | Description of NC<br>Section A   | Corrective Action Section B |                                 |                | Verification<br>Section C | Approval<br>Chief Eng | Approval<br>QC Inspector |
|      |      |                                  | Initial<br>Chief Eng        | Action Description<br>Chief Eng | Sign &<br>Date |                           |                       |                          |
|      |      |                                  |                             |                                 |                |                           |                       |                          |
**NOTE:** Date & initial all entries

Date: Monday, 1/16/2006 4:11:21 PM  
User: Kim Johnston

## Process Sheet

Customer: CU-DAR001 Dart Helicopters Services

Drawing Name: COLLECTIVE LOCK

Job Number: 25501

Part Number: D3372041

Job Number:



Seq. #:

Machine Or Operation:

Description :

11.0

AN960416

Washer



Comment: Qty.: 2.0000 Each(s)/Unit Total : 10.0000 Each(s)

Pick:

Qty Part Number Description Batch

2 AN960-416 Washer M5519

12.0

HX81

1/4"-20 SHCS 3/8" long



Comment: Qty.: 1.0000 Each(s)/Unit Total : 5.0000 Each(s)

Pick:

Qty Part Number Description Batch

1 HX-81 1/4"-20 SHCS 3/8" long M16971

13.0

SMALL FAB 1

SMALL & MEDIUM FAB RESOURCE 1



Comment: SMALL & MEDIUM FAB RESOURCE 1

Fabricate D3372-3 using AN5-42A bolt as per Dwg D3372

Identify as D3372-3

FF 06-02-01

14.0

QC5

INSPECT WORK TO CURRENT STEP



Comment: INSPECT WORK TO CURRENT STEP

SB 06/02/01

15.0

SMALL FAB 1

SMALL & MEDIUM FAB RESOURCE 1



Comment: SMALL & MEDIUM FAB RESOURCE 1

1-Open Cam Lock package. Keep keys, lock body, lock body nut, flat cam and lock barrel. Discard the rest.

2-Fabricate D3369-5 spacer using the flat cam as per Dwg D3369 Identify as D3369-5

SB 06/02/01

16.0

LARGE FAB 1

LARGE FABRICATION RESOURCE 1



Comment: LARGE FABRICATION RESOURCE 1

Tack weld lock shaft as per Dwg D3372

Qty Part Number Description Batch

A/R/N/A

SS Rod

M19555

PD 06-02-01

| W/O: |      | WORK ORDER CHANGES |    |      |     |                                     |                          |
|------|------|--------------------|----|------|-----|-------------------------------------|--------------------------|
| DATE | STEP | PROCEDURE CHANGE   | By | Date | Qty | Approval<br>Chief Eng /<br>Prod Mgr | Approval<br>QC Inspector |
|      |      |                    |    |      |     |                                     |                          |
|      |      |                    |    |      |     |                                     |                          |

Part No: \_\_\_\_\_ PAR #: \_\_\_\_\_ Fault Category: \_\_\_\_\_ NCR: Yes No DQA: \_\_\_\_\_ Date: \_\_\_\_\_

QA: N/C Closed: \_\_\_\_\_ Date: \_\_\_\_\_

| NCR: |      | WORK ORDER NON-CONFORMANCE (NCR) |                             |                                 |                |                           |                       |                          |
|------|------|----------------------------------|-----------------------------|---------------------------------|----------------|---------------------------|-----------------------|--------------------------|
| DATE | STEP | Description of NC<br>Section A   | Corrective Action Section B |                                 |                | Verification<br>Section C | Approval<br>Chief Eng | Approval<br>QC Inspector |
|      |      |                                  | Initial<br>Chief Eng        | Action Description<br>Chief Eng | Sign &<br>Date |                           |                       |                          |
|      |      |                                  |                             |                                 |                |                           |                       |                          |
NOTE: Date & initial all entries

Date: Monday, 1/16/2006 4:11:21 PM  
User: Kim Johnston

## Process Sheet

Customer: CU-DAR001 Dart Helicopters Services

Drawing Name: COLLECTIVE LOCK

Job Number: 25501

Part Number: D3372041

Job Number:



Seq. #:

Machine Or Operation:

Description :

17.0

SMALL FAB 1

SMALL & MEDIUM FAB RESOURCE 1



Comment: SMALL & MEDIUM FAB RESOURCE 1

1-Assemble D3372-053 as per Dwg D3372. Apply a drop of permanent locktite 262 to the threads

Qty Part Number Description Batch

A/R N/A Locktite 262 ML6507

Identify as D3372-053

2-Assemble D3372-051 as per Dwg D3372. Identify as D3372-051 and attach keys Ensure that assembly locks and unlocks smoothly.

3-Assemble lanyard to cyclic sock as per Dwg D3384

4-Assemble D3384-043 to D3372-051 using 1/4"-20 socket head cap screw and washers as per Dwg D3371.

SB 06/02/01

18.0

QC5

INSPECT WORK TO CURRENT STEP



Comment: INSPECT WORK TO CURRENT STEP

06.02.01

19.0

PACKAGING 1

PACKAGING RESOURCE #1



Comment: PACKAGING RESOURCE #1

Identify and Stock

Location:                     

Record Key #

~~C413A~~ C420A  
~~C413A~~ C420A  
~~C413A~~ C420A  
~~C413A~~ C420A

C 206/02/01 4

20.0

DC

DOCUMENT CONTROL



Comment: DOCUMENT CONTROL

Inspection Level 21

545 06/02/02

(4)

SP 06/02/02 (4)

Job Completion



| W/O: |      | WORK ORDER CHANGES |    |      |     |                                     |                          |
|------|------|--------------------|----|------|-----|-------------------------------------|--------------------------|
| DATE | STEP | PROCEDURE CHANGE   | By | Date | Qty | Approval<br>Chief Eng /<br>Prod Mgr | Approval<br>QC Inspector |
|      |      |                    |    |      |     |                                     |                          |
|      |      |                    |    |      |     |                                     |                          |

Part No: \_\_\_\_\_ PAR #: \_\_\_\_\_ Fault Category: \_\_\_\_\_ NCR: Yes No DQA: \_\_\_\_\_ Date: \_\_\_\_\_

QA: N/C Closed: \_\_\_\_\_ Date: \_\_\_\_\_


| NCR: |      | WORK ORDER NON-CONFORMANCE (NCR) |                             |                                 |                |                           |                       |                          |
|------|------|----------------------------------|-----------------------------|---------------------------------|----------------|---------------------------|-----------------------|--------------------------|
| DATE | STEP | Description of NC<br>Section A   | Corrective Action Section B |                                 |                | Verification<br>Section C | Approval<br>Chief Eng | Approval<br>QC Inspector |
|      |      |                                  | Initial<br>Chief Eng        | Action Description<br>Chief Eng | Sign &<br>Date |                           |                       |                          |
|      |      |                                  |                             |                                 |                |                           |                       |                          |
NOTE: Date & initial all entries







|                               |                                |  |                        |
|-------------------------------|--------------------------------|--|------------------------|
| DESIGN<br><i>[Signature]</i>  | DRAWN BY<br><i>[Signature]</i> | <b>DART AEROSPACE LTD</b><br>HAWKESBURY, ONTARIO, CANADA                       |                        |
| CHECKED<br><i>[Signature]</i> | APPROVED<br><i>[Signature]</i> | DRAWING NO.<br><b>D3372</b>  | REV. B<br>SHEET 1 OF 8 |
| DATE<br><b>05.02.23</b>       |                                | TITLE<br><b>COLLECTIVE LOCK</b>  | SCALE<br>1:2           |
| A                             | 05.01.10                       | NEW ISSUE  |                        |
| B                             | 05.02.23                       | REDESIGN FOR STANDARD 1/4 TURN LOCK,<br>D3369-5 SUPERCEDES D3372-11 (OBSOLETE) |                        |

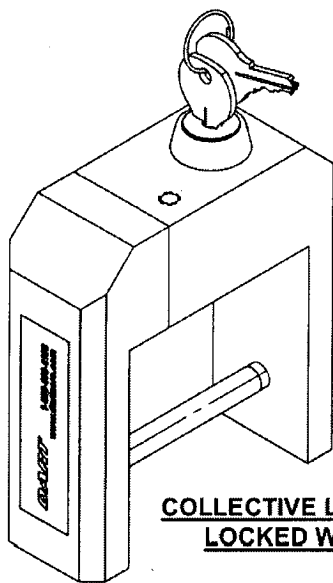

**COLLECTIVE LOCK SHOWN  
LOCKED WITH KEYS**

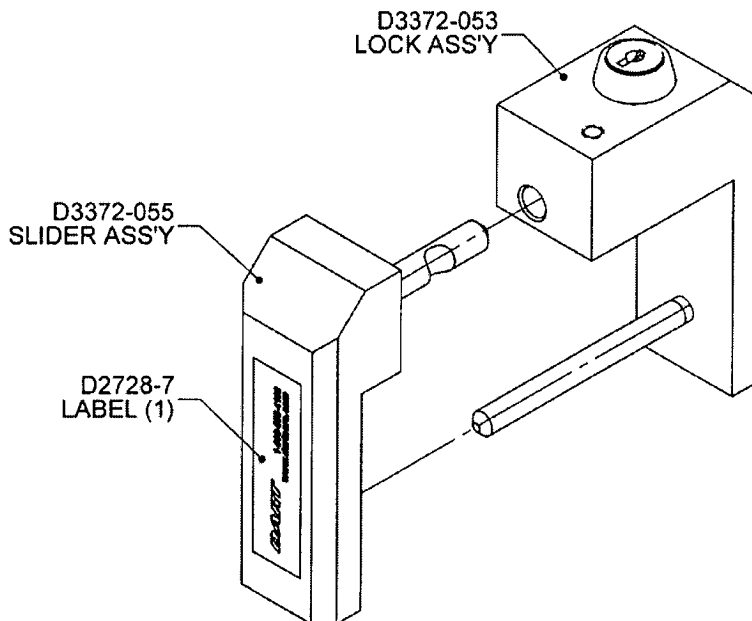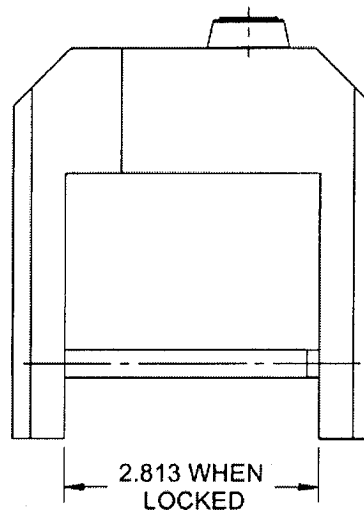

**D3372-051 AS350 COLLECTIVE LOCK ASS'Y**

**NOTES:**

- 1) TOLERANCES ARE PER DART QSI 018 UNLESS OTHERWISE NOTED
- 2) ALL DIMENSIONS ARE IN INCHES

**RELEASED**  
*[Signature]*  
05/04/28

**SHOP COPY  
RETURN TO  
ENGINEERING  
UNCONTROLLED COPY  
SUBJECT TO REWORK  
WITHOUT NOTICE  
WORK ORDER  
NO. 25501**




**COPYRIGHT © 2005 BY DART AEROSPACE LTD.**

THIS DOCUMENT IS PRIVATE AND CONFIDENTIAL AND IS SUPPLIED ON THE EXPRESS CONDITION THAT IT IS NOT TO BE USED FOR ANY PURPOSE OR COPIED OR COMMUNICATED TO ANY OTHER PERSON WITHOUT WRITTEN PERMISSION FROM DART AEROSPACE LTD.



|                               |                                |  |                        |
|-------------------------------|--------------------------------|--|------------------------|
| DESIGN<br><i>[Signature]</i>  | DRAWN BY<br><i>[Signature]</i> | <b>DART AEROSPACE LTD</b><br>HAWKESBURY, ONTARIO, CANADA |                        |
| CHECKED<br><i>[Signature]</i> | APPROVED<br><i>[Signature]</i> | DRAWING NO.<br><b>D3372</b>                              | REV. B<br>SHEET 2 OF 8 |
| DATE<br><b>05.02.23</b>       |                                | TITLE<br><b>COLLECTIVE LOCK</b>                          | SCALE<br>1:2           |

**RELEASED**  
*[Signature]*  
05/04/23

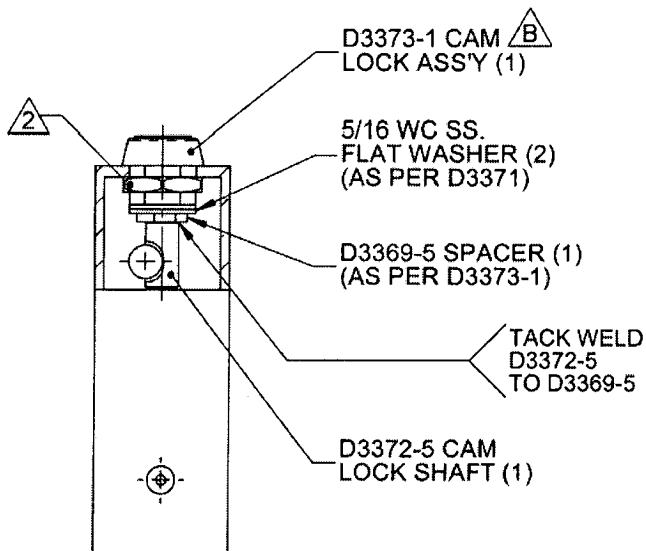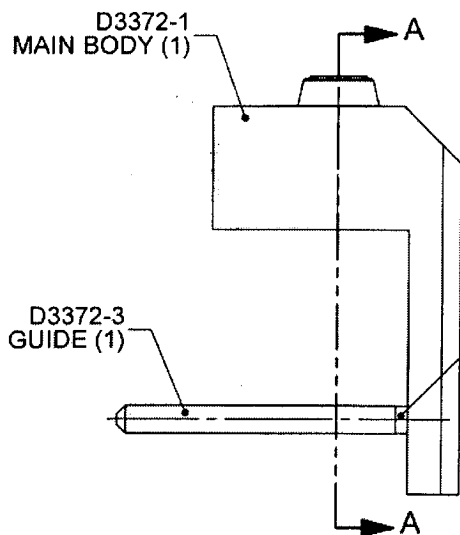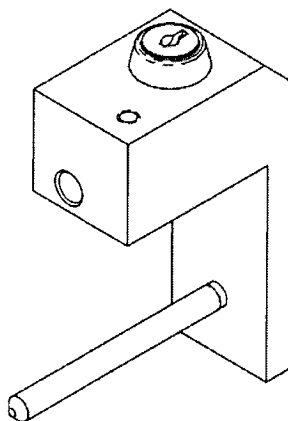

**SECTION A-A**

**D3372-053 LOCK ASS'Y**


**NOTES:**

- 1) WELD PER DART QSI 004
- 2) APPLY THREADLOCKER LOCTITE 262 ON THREADS

SHOP COPY  
RETURN TO  
ENGINEERING  
UNCONTROLLED COPY  
SUSCEPTIBLE TO  
WITHOUT NOTICE  
WORK ORDER  
NO. 25501




**COPYRIGHT © 2005 BY DART AEROSPACE LTD.**

THIS DOCUMENT IS PRIVATE AND CONFIDENTIAL AND IS SUPPLIED ON THE EXPRESS CONDITION THAT IT IS NOT TO BE USED FOR ANY PURPOSE OR COPIED OR COMMUNICATED TO ANY OTHER PERSON WITHOUT WRITTEN PERMISSION FROM DART AEROSPACE LTD.

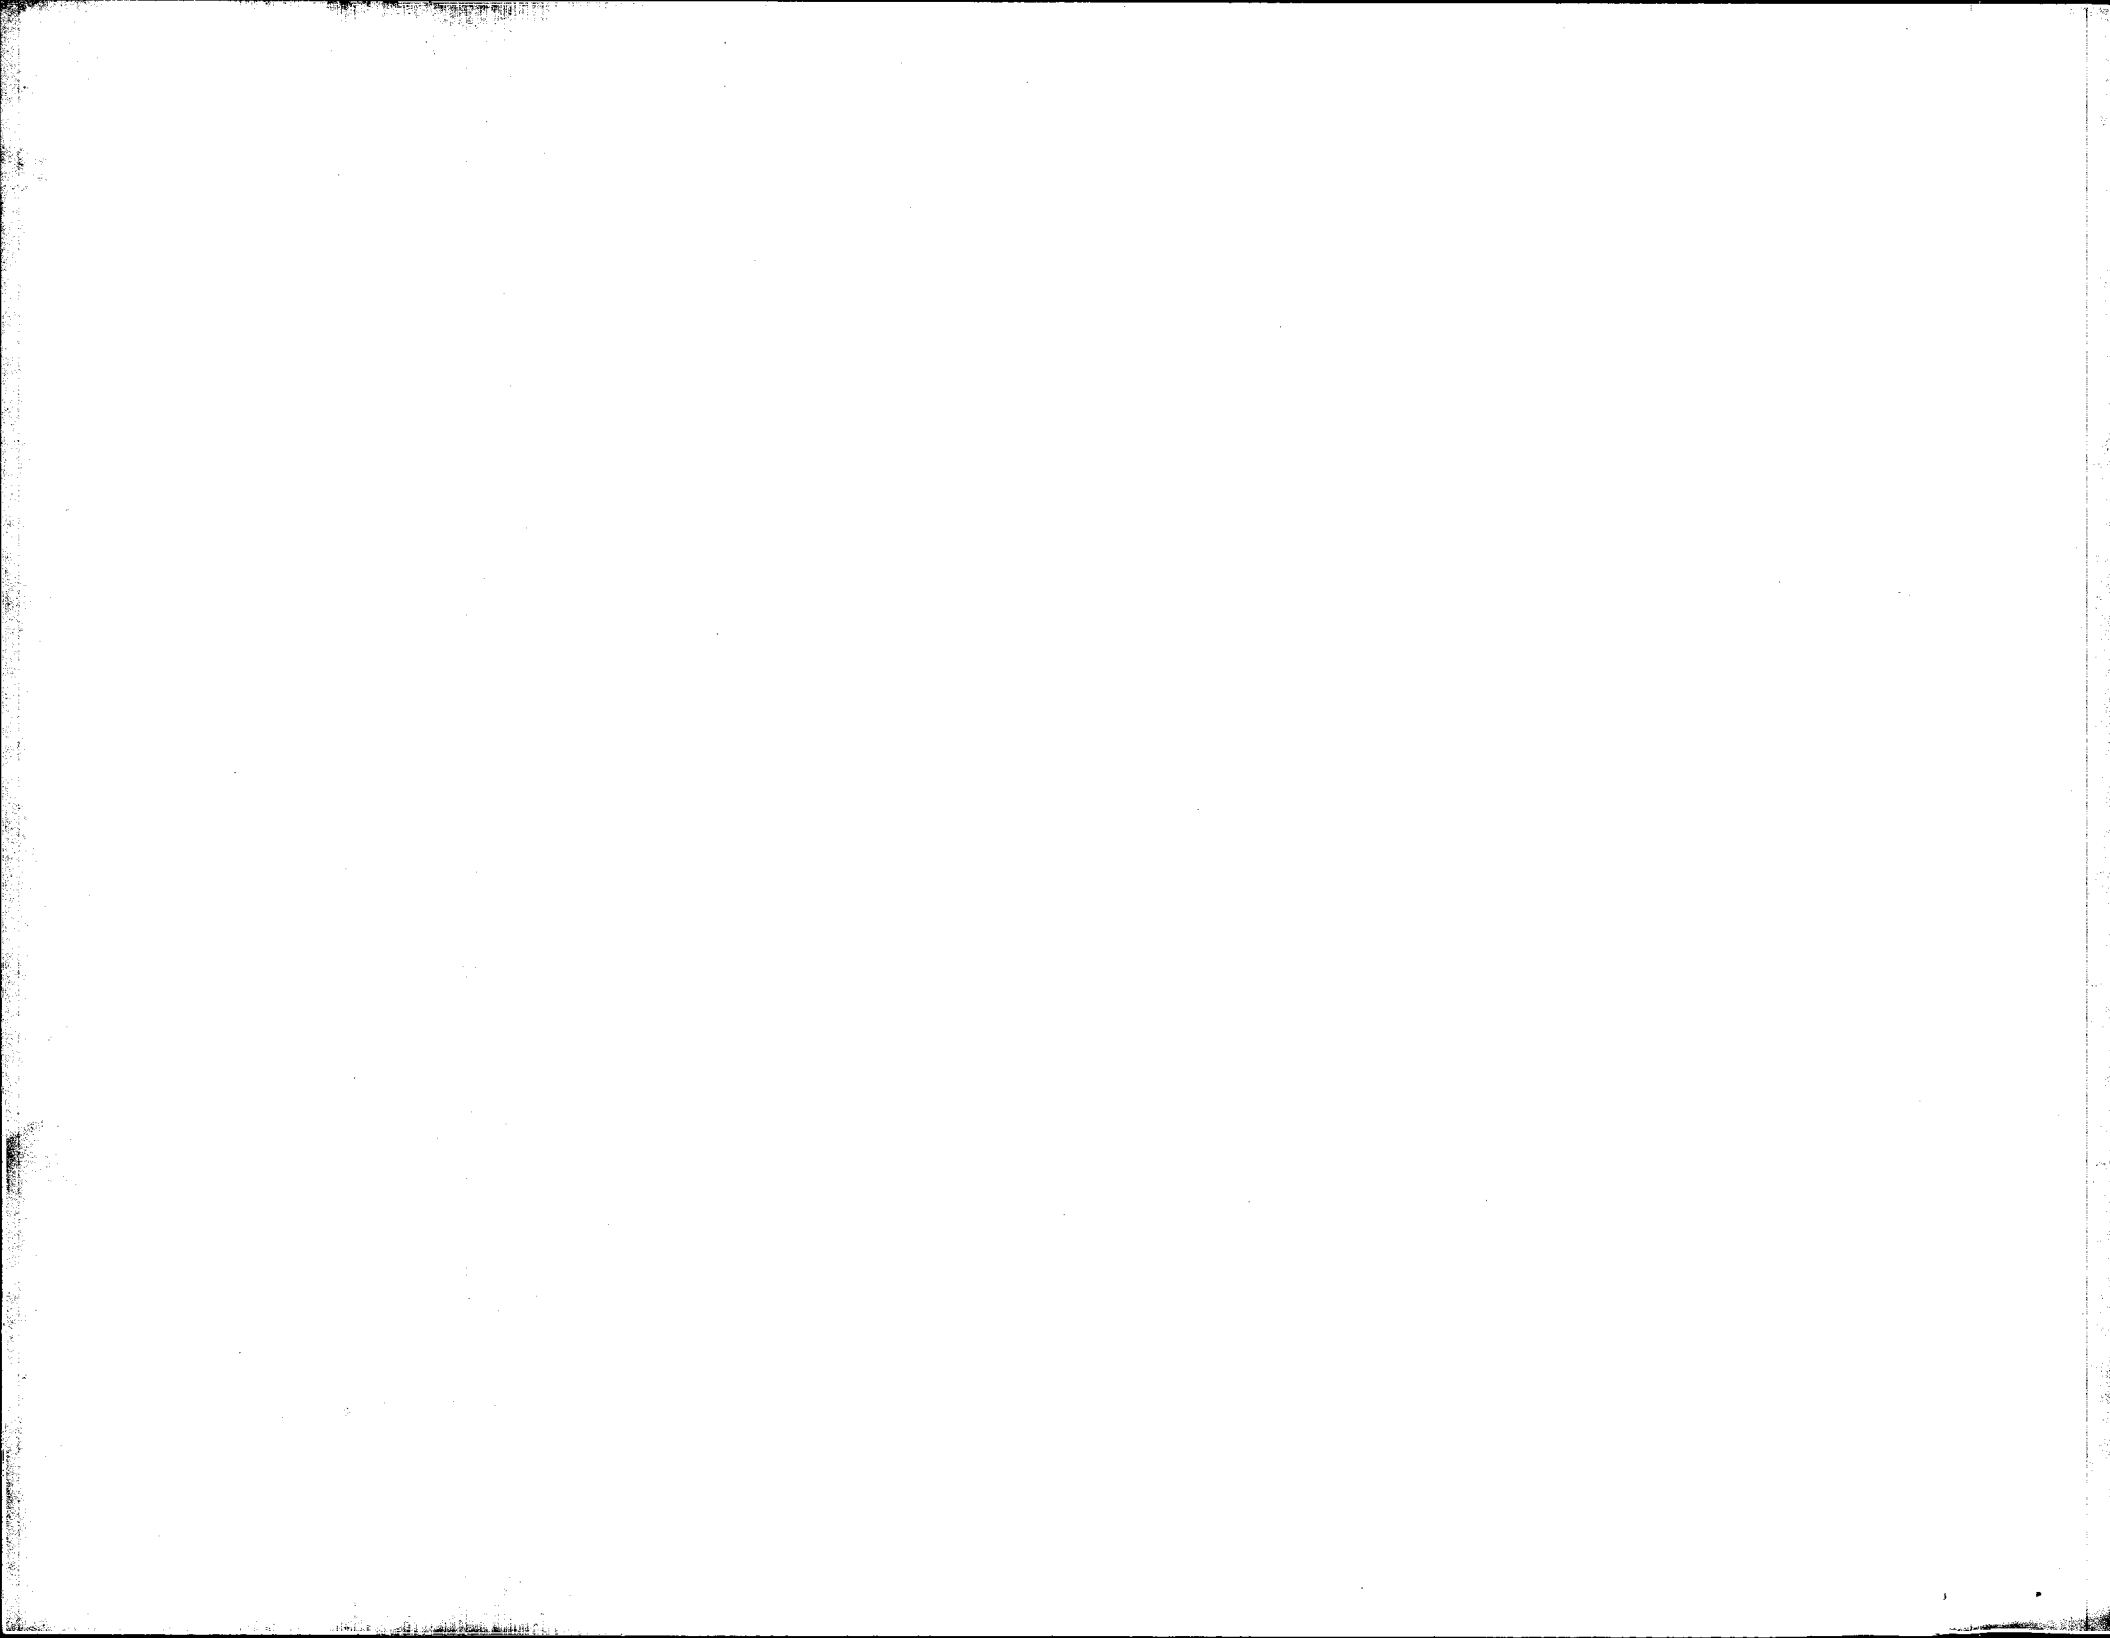

**DART**

|                               |                                |  |                        |
|-------------------------------|--------------------------------|--|------------------------|
| DESIGN<br><i>[Signature]</i>  | DRAWN BY<br><i>[Signature]</i> | <b>DART AEROSPACE LTD</b><br>HAWKESBURY, ONTARIO, CANADA |                        |
| CHECKED<br><i>[Signature]</i> | APPROVED<br><i>[Signature]</i> | DRAWING NO.<br><b>D3372</b>                              | REV. B<br>SHEET 3 OF 8 |
| DATE<br><b>05.02.23</b>       |                                | TITLE<br><b>COLLECTIVE LOCK</b>                          | SCALE<br>1:2           |

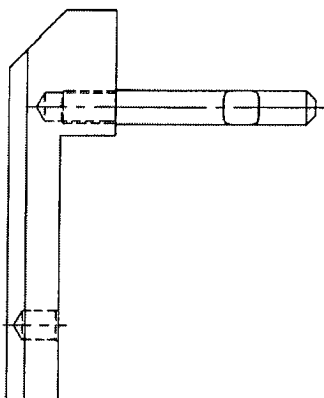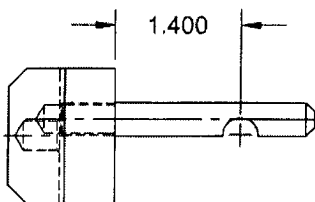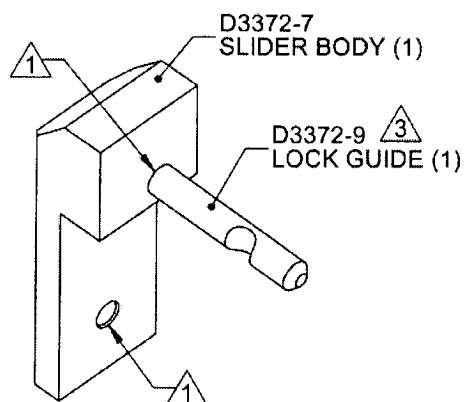**RELEASED**  
*[Signature]*  
05/04/23**D3372-055 SLIDER ASS'Y****NOTES:**

- 1) COVER INSIDE HOLES AND D3372-9 PRIOR PAINTING
- 2) FINISH: POWDER COAT PAINT FIRE RED (4.3.5.10) PER DART QSI 005 4.3
- 3) APPLY THREADLOCKER LOCTITE 262 ON D3372-9 THREADS PRIOR ASSEMBLY
- 4) TOLERANCES ARE PER DART QSI 018 UNLESS OTHERWISE NOTED
- 5) ALL DIMENSIONS ARE IN INCHES

NO COPY  
RETURN TO  
BUSINESS  
NO COPY  
SHOULD TO  
WITHOUT NOTICE


WORK ORDER  
NO. 25501

**COPYRIGHT © 2005 BY DART AEROSPACE LTD.**

THIS DOCUMENT IS PRIVATE AND CONFIDENTIAL AND IS SUPPLIED ON THE EXPRESS CONDITION THAT IT IS NOT TO BE USED FOR ANY PURPOSE OR COPIED OR COMMUNICATED TO ANY OTHER PERSON WITHOUT WRITTEN PERMISSION FROM DART AEROSPACE LTD.

**DART**

|                         |                         |  |                        |
|-------------------------|-------------------------|--|------------------------|
| DESIGN<br>13            | DRAWN BY<br>13          | <b>DART AEROSPACE LTD</b><br>HAWKESBURY, ONTARIO, CANADA |                        |
| CHECKED<br>77           | APPROVED<br>[Signature] | DRAWING NO.<br><b>D3372</b>                              | REV. B<br>SHEET 4 OF 8 |
| DATE<br><b>05.02.23</b> |                         | TITLE<br><b>COLLECTIVE LOCK</b>                          | SCALE<br>1:2           |

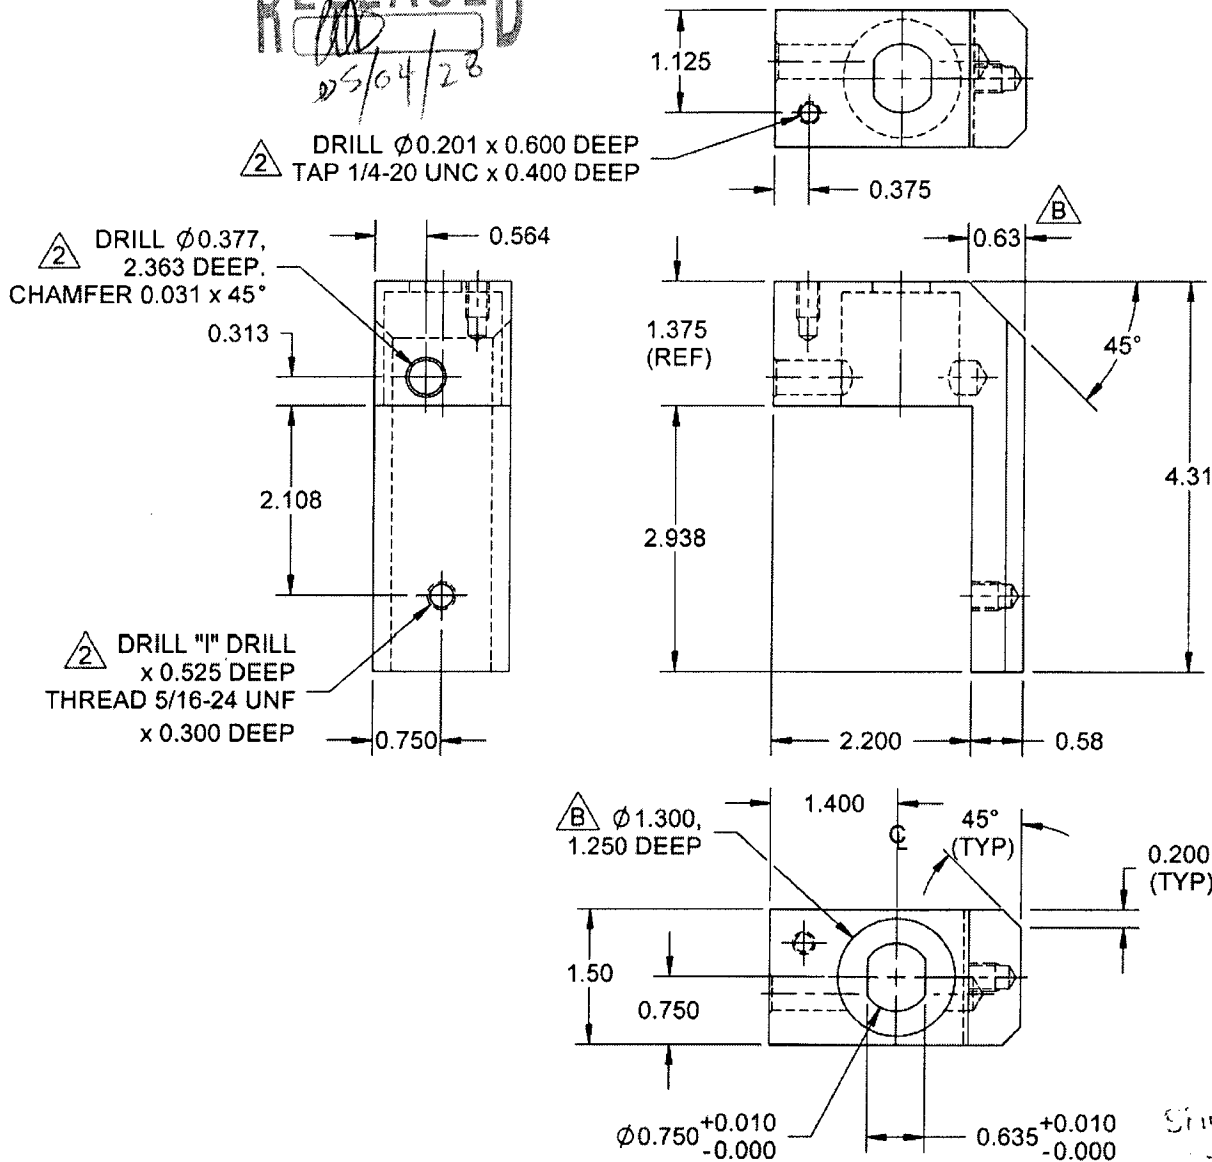**RELEASED**  
05/04/23**D3372-1 MAIN BODY****NOTES:**

- 1) MATERIAL: 6061-T6/T651 (QQ-A-200/8 OR QQ-A-225/8)  
(REF. DART SPEC. M6061T6B)
- 2) COVER INSIDE HOLES PRIOR PAINTING
- 3) FINISH: CHEMICAL CONVERSION COAT PER DART QSI 005 4.1  
POWDER COAT FIRE RED (4.3.5.10) PER DART QSI 005 4.3
- 4) TOLERANCES ARE PER DART QSI 018 UNLESS OTHERWISE NOTED
- 5) ALL DIMENSIONS ARE IN INCHES
- 6) BREAK ALL SHARP EDGES 0.005 TO 0.010

SHOP COPY  
RETURN TO  
ENGINEERINGCONTROLLED COPY  
SUBMITTAL  
REVISION NOTICEWORK ORDER  
No. 25501

COPYRIGHT © 2005 BY DART AEROSPACE LTD.


THIS DOCUMENT IS PRIVATE AND CONFIDENTIAL AND IS SUPPLIED ON THE EXPRESS CONDITION THAT IT IS NOT TO BE USED FOR ANY PURPOSE OR COPIED OR COMMUNICATED TO ANY OTHER PERSON WITHOUT WRITTEN PERMISSION FROM DART AEROSPACE LTD.



|                               |                                |   |                        |
|-------------------------------|--------------------------------|---|------------------------|
| DESIGN<br><i>[Signature]</i>  | DRAWN BY<br><i>[Signature]</i> | DART AEROSPACE LTD<br>HAWKESBURY, ONTARIO, CANADA |                        |
| CHECKED<br><i>[Signature]</i> | APPROVED<br><i>[Signature]</i> | DRAWING NO.<br>D3372                              | REV. B<br>SHEET 5 OF 8 |
| DATE<br>05.02.23              |                                | TITLE<br>COLLECTIVE LOCK                          | SCALE<br>1:1           |

## SPECIFICATION CONTROL DRAWING

RELEASED  
*[Signature]*  
05/04/23

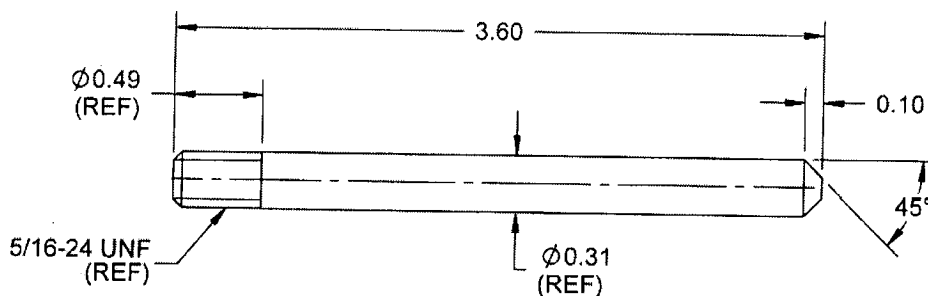

### D3372-3 GUIDE

#### NOTES:

- 1) MATERIAL: AN5-42A BOLT MODIFIED AS SHOWN.
- 2) TOLERANCES ARE PER DART QSI 018 UNLESS OTHERWISE NOTED
- 3) ALL DIMENSIONS ARE IN INCHES
- 4) BREAK ALL SHARP EDGES 0.005 TO 0.010

SHOP COPY  
RETURN TO  
ENGINEERING  
UNCONTROLLED COPY  
SUBJECT TO  
WITH  
W/O  
NO. 25501


COPYRIGHT © 2005 BY DART AEROSPACE LTD.

THIS DOCUMENT IS PRIVATE AND CONFIDENTIAL AND IS SUPPLIED ON THE EXPRESS CONDITION THAT IT IS NOT TO BE USED FOR ANY PURPOSE OR COPIED OR COMMUNICATED TO ANY OTHER PERSON WITHOUT WRITTEN PERMISSION FROM DART AEROSPACE LTD.

**DART**

|                         |                         |  |                        |
|-------------------------|-------------------------|--|------------------------|
| DESIGN<br>3             | DRAWN BY<br>[Signature] | <b>DART AEROSPACE LTD</b><br>HAWKESBURY, ONTARIO, CANADA |                        |
| CHECKED<br>[Signature]  | APPROVED<br>[Signature] | DRAWING NO.<br><b>D3372</b>                              | REV. B<br>SHEET 6 OF 8 |
| DATE<br><b>05.02.23</b> |                         | TITLE<br><b>COLLECTIVE LOCK</b>                          | SCALE<br>2:1           |

RELEASED  
[Signature]  
05/04/28

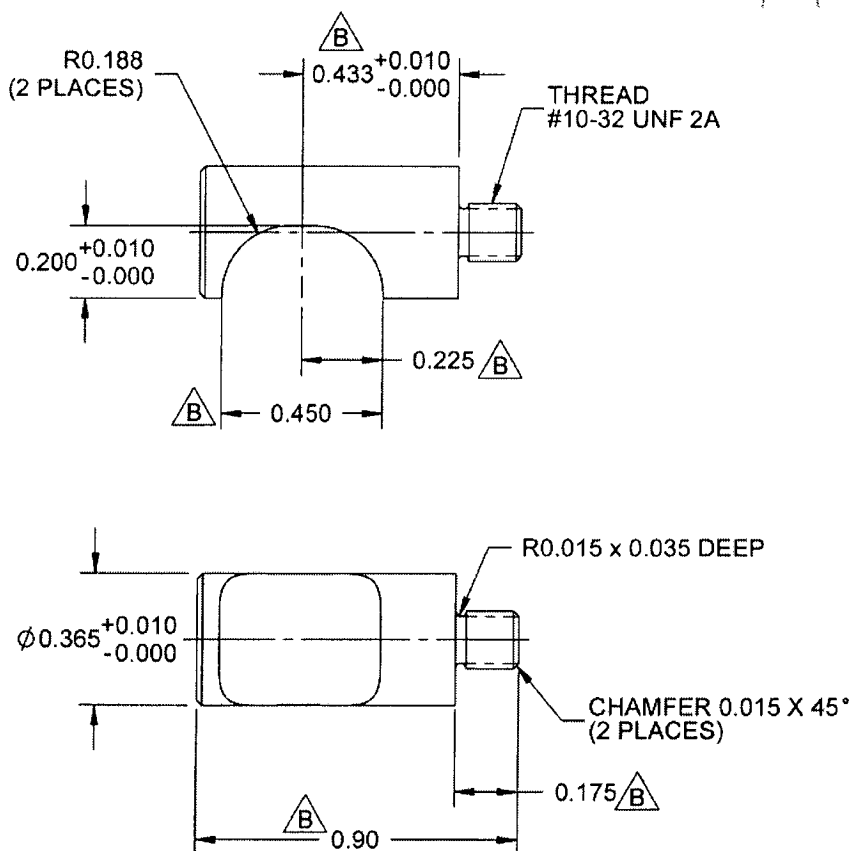

### D3372-5 CAM LOCK SHAFT

#### NOTES:

- 1) MATERIAL: AISI 303 S.S. (REF. DART SPEC. M303R0.375)
- 2) TOLERANCES ARE PER DART QSI 018 UNLESS OTHERWISE NOTED
- 3) ALL DIMENSIONS ARE IN INCHES
- 4) BREAK ALL SHARP EDGES 0.005 TO 0.010

SHOP COPY  
RETURN TO  
ENGINEERING  
UNCONTROLLED COPY  
SUBJECT TO [Signature]  
WITHOUT NOT

WORK ORDER  
NO. 25501

COPYRIGHT © 2005 BY DART AEROSPACE LTD.


THIS DOCUMENT IS PRIVATE AND CONFIDENTIAL AND IS SUPPLIED ON THE EXPRESS CONDITION THAT IT IS NOT TO BE USED FOR ANY PURPOSE OR COPIED OR COMMUNICATED TO ANY OTHER PERSON WITHOUT WRITTEN PERMISSION FROM DART AEROSPACE LTD.

**DART**

|                               |                                |  |                        |
|-------------------------------|--------------------------------|--|------------------------|
| DESIGN<br><i>[Signature]</i>  | DRAWN BY<br><i>[Signature]</i> | <b>DART AEROSPACE LTD</b><br>HAWKESBURY, ONTARIO, CANADA |                        |
| CHECKED<br><i>[Signature]</i> | APPROVED<br><i>[Signature]</i> | DRAWING NO.<br><b>D3372</b>                              | REV. B<br>SHEET 7 OF 8 |
| DATE<br><b>05.02.23</b>       |                                | TITLE<br><b>COLLECTIVE LOCK</b>                          | SCALE<br>1:2           |

DRILL  $\phi 0.332$   
("Q" DRILL) x 0.881 DEEP,  
THREAD 3/8-24 UNF x 0.600 DEEP

DRILL  $\phi 0.323$   
("P" DRILL) x 0.500 DEEP  
CHAMFER 0.030 x 30°

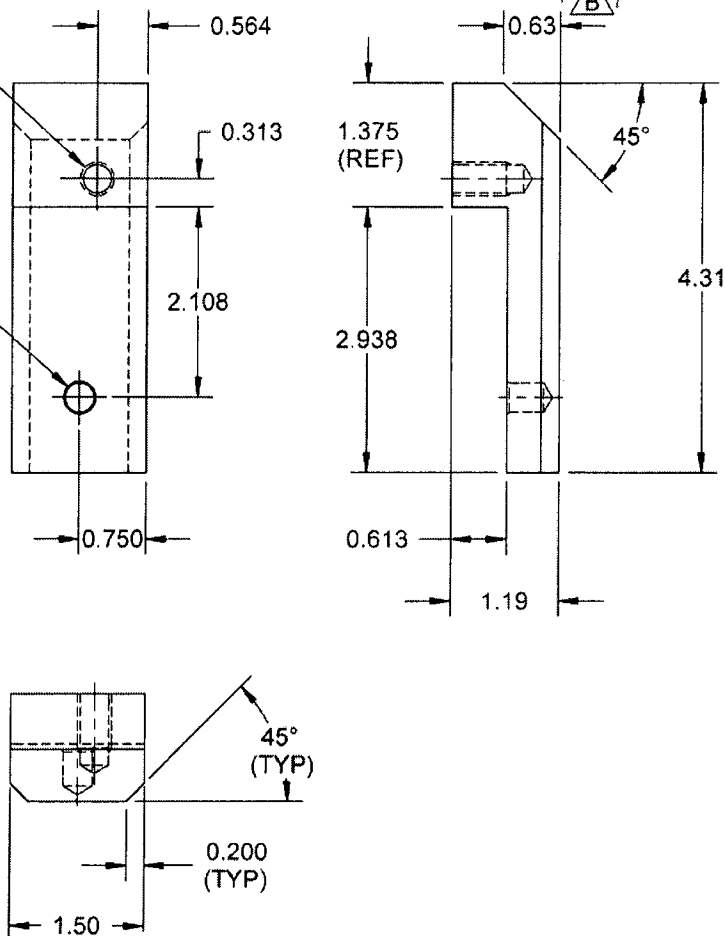

### D3372-7 SLIDER BODY

#### NOTES:

- 1) MATERIAL: 6061-T6/T651 (QQ-A-200/8 OR QQ-A-225/8)  
(REF. DART SPEC. M6061T6B)
- 2) FINISH: CHEMICAL CONVERSION COAT PER DART QSI 005 4.1
- 3) TOLERANCES ARE PER DART QSI 018 UNLESS OTHERWISE NOTED
- 4) ALL DIMENSIONS ARE IN INCHES
- 5) BREAK ALL SHARP EDGES 0.005 TO 0.010

SHOP COPY  
RETURN TO  
ENGINEERING  
UNCONTROLLED COPY  
SUBJECT TO A CHANGE  
WITHOUT NOTICE  
WORK ORDER  
NO. 25501

COPYRIGHT © 2005 BY DART AEROSPACE LTD.


THIS DOCUMENT IS PRIVATE AND CONFIDENTIAL AND IS SUPPLIED ON THE EXPRESS CONDITION THAT IT IS NOT TO BE USED FOR ANY PURPOSE OR COPIED OR COMMUNICATED TO ANY OTHER PERSON WITHOUT WRITTEN PERMISSION FROM DART AEROSPACE LTD.





|                               |                                |   |                        |
|-------------------------------|--------------------------------|---|------------------------|
| DESIGN<br><i>[Signature]</i>  | DRAWN BY<br><i>[Signature]</i> | DART AEROSPACE LTD<br>HAWKESBURY, ONTARIO, CANADA |                        |
| CHECKED<br><i>[Signature]</i> | APPROVED<br><i>[Signature]</i> | DRAWING NO.<br>D3372                              | REV. B<br>SHEET 8 OF 8 |
| DATE<br>05.02.23              |                                | TITLE<br>COLLECTIVE LOCK                          | SCALE<br>2:1           |

## SPECIFICATION CONTROL DRAWING

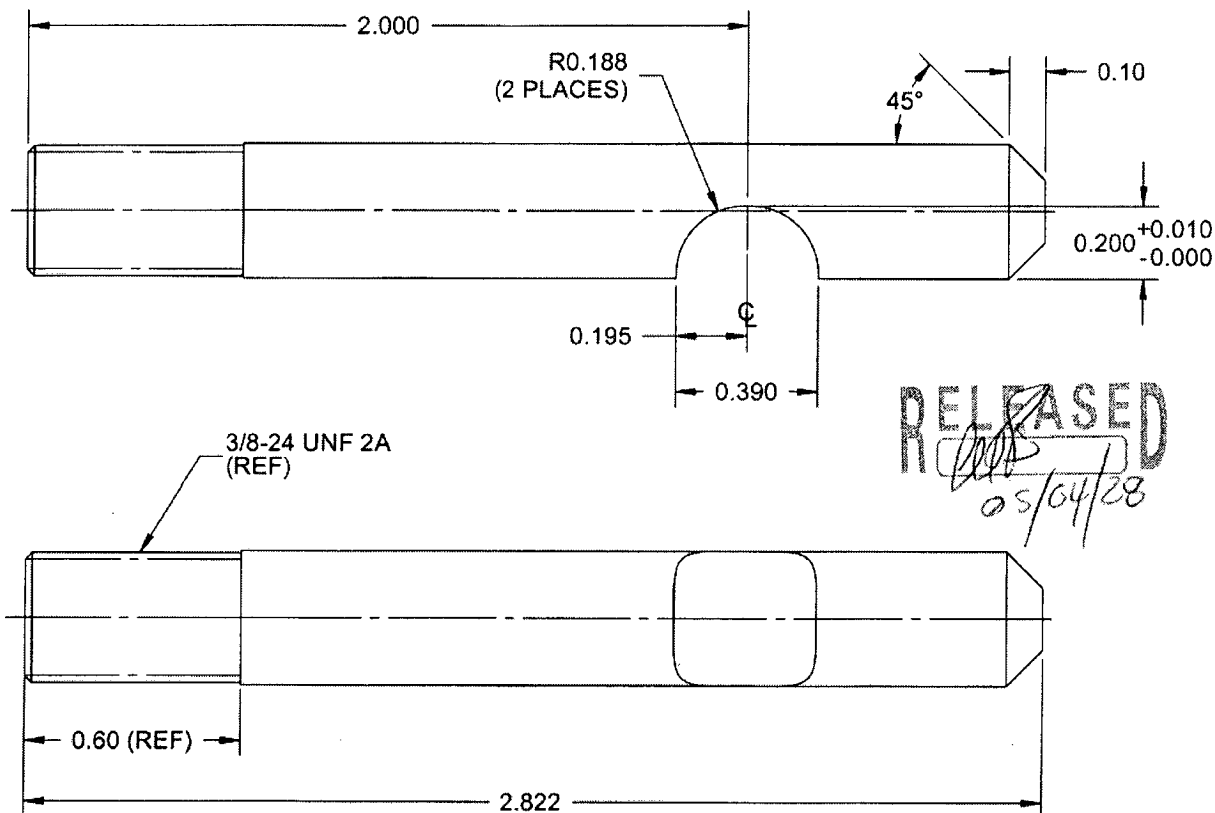

RELEASED  
*[Signature]*  
05/04/28

### D3372-9 LOCK GUIDE

#### NOTES:

- 1) MATERIAL: AN6-36A BOLT, MODIFIED AS SHOWN
- 2) TOLERANCES ARE PER DART QSI 018 UNLESS OTHERWISE NOTED
- 3) ALL DIMENSIONS ARE IN INCHES
- 4) BREAK ALL SHARP EDGES 0.005 TO 0.010

GROUP COPY  
RETURN TO  
ENGINEERING

UNCONTROLLED COPY  
NOT TO BE USED  
WITHOUT NOTICE

WORK ORDER  
no 25501

COPYRIGHT © 2005 BY DART AEROSPACE LTD.

THIS DOCUMENT IS PRIVATE AND CONFIDENTIAL AND IS SUPPLIED ON THE EXPRESS CONDITION THAT IT IS NOT TO BE USED FOR ANY PURPOSE OR COPIED OR COMMUNICATED TO ANY OTHER PERSON WITHOUT WRITTEN PERMISSION FROM DART AEROSPACE LTD.

